


脇谷水門


上流

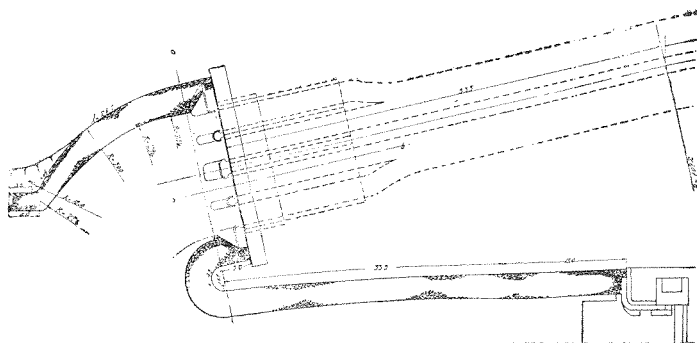


(21) 脇谷水門竣工圖


断面 a-a

断面 b-b

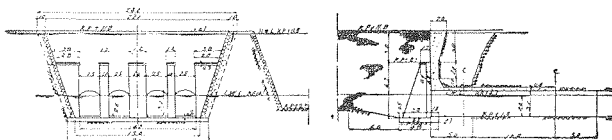

(22) 脇谷水門上流取入口を望む。(5.10.22)

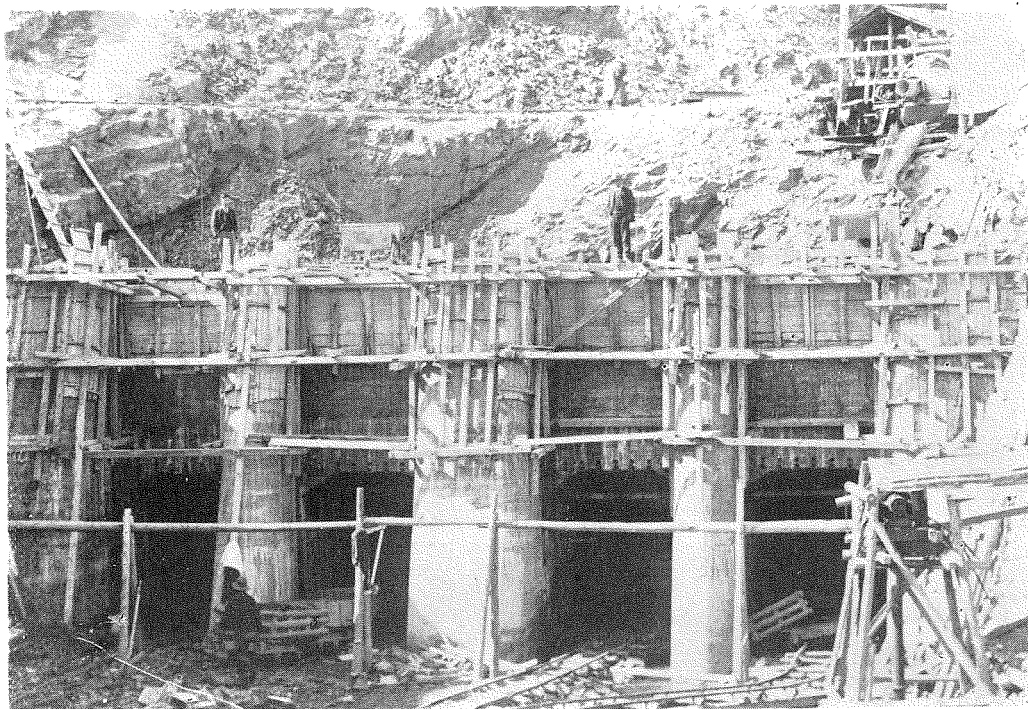

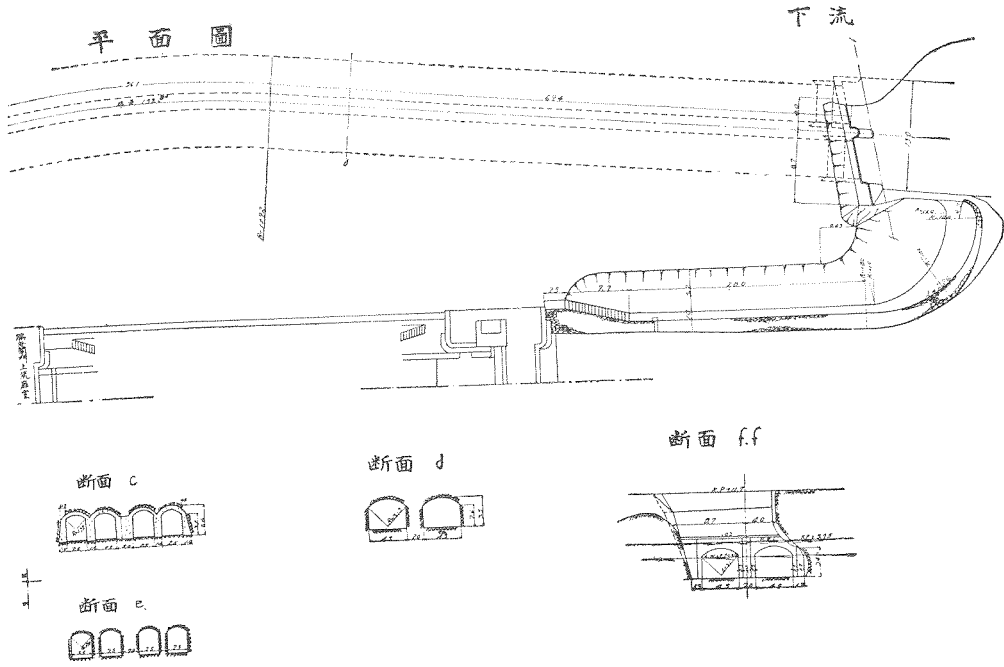

(23) 脇谷水門下流吐口。(5.10.22)

